
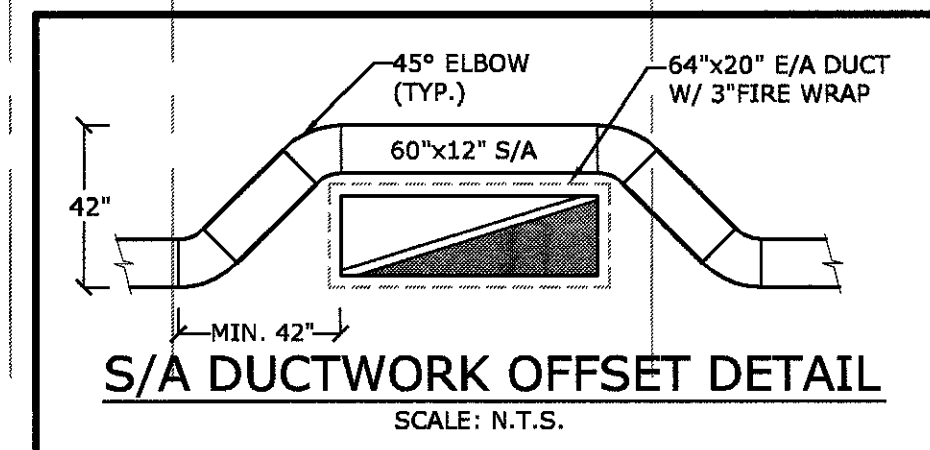


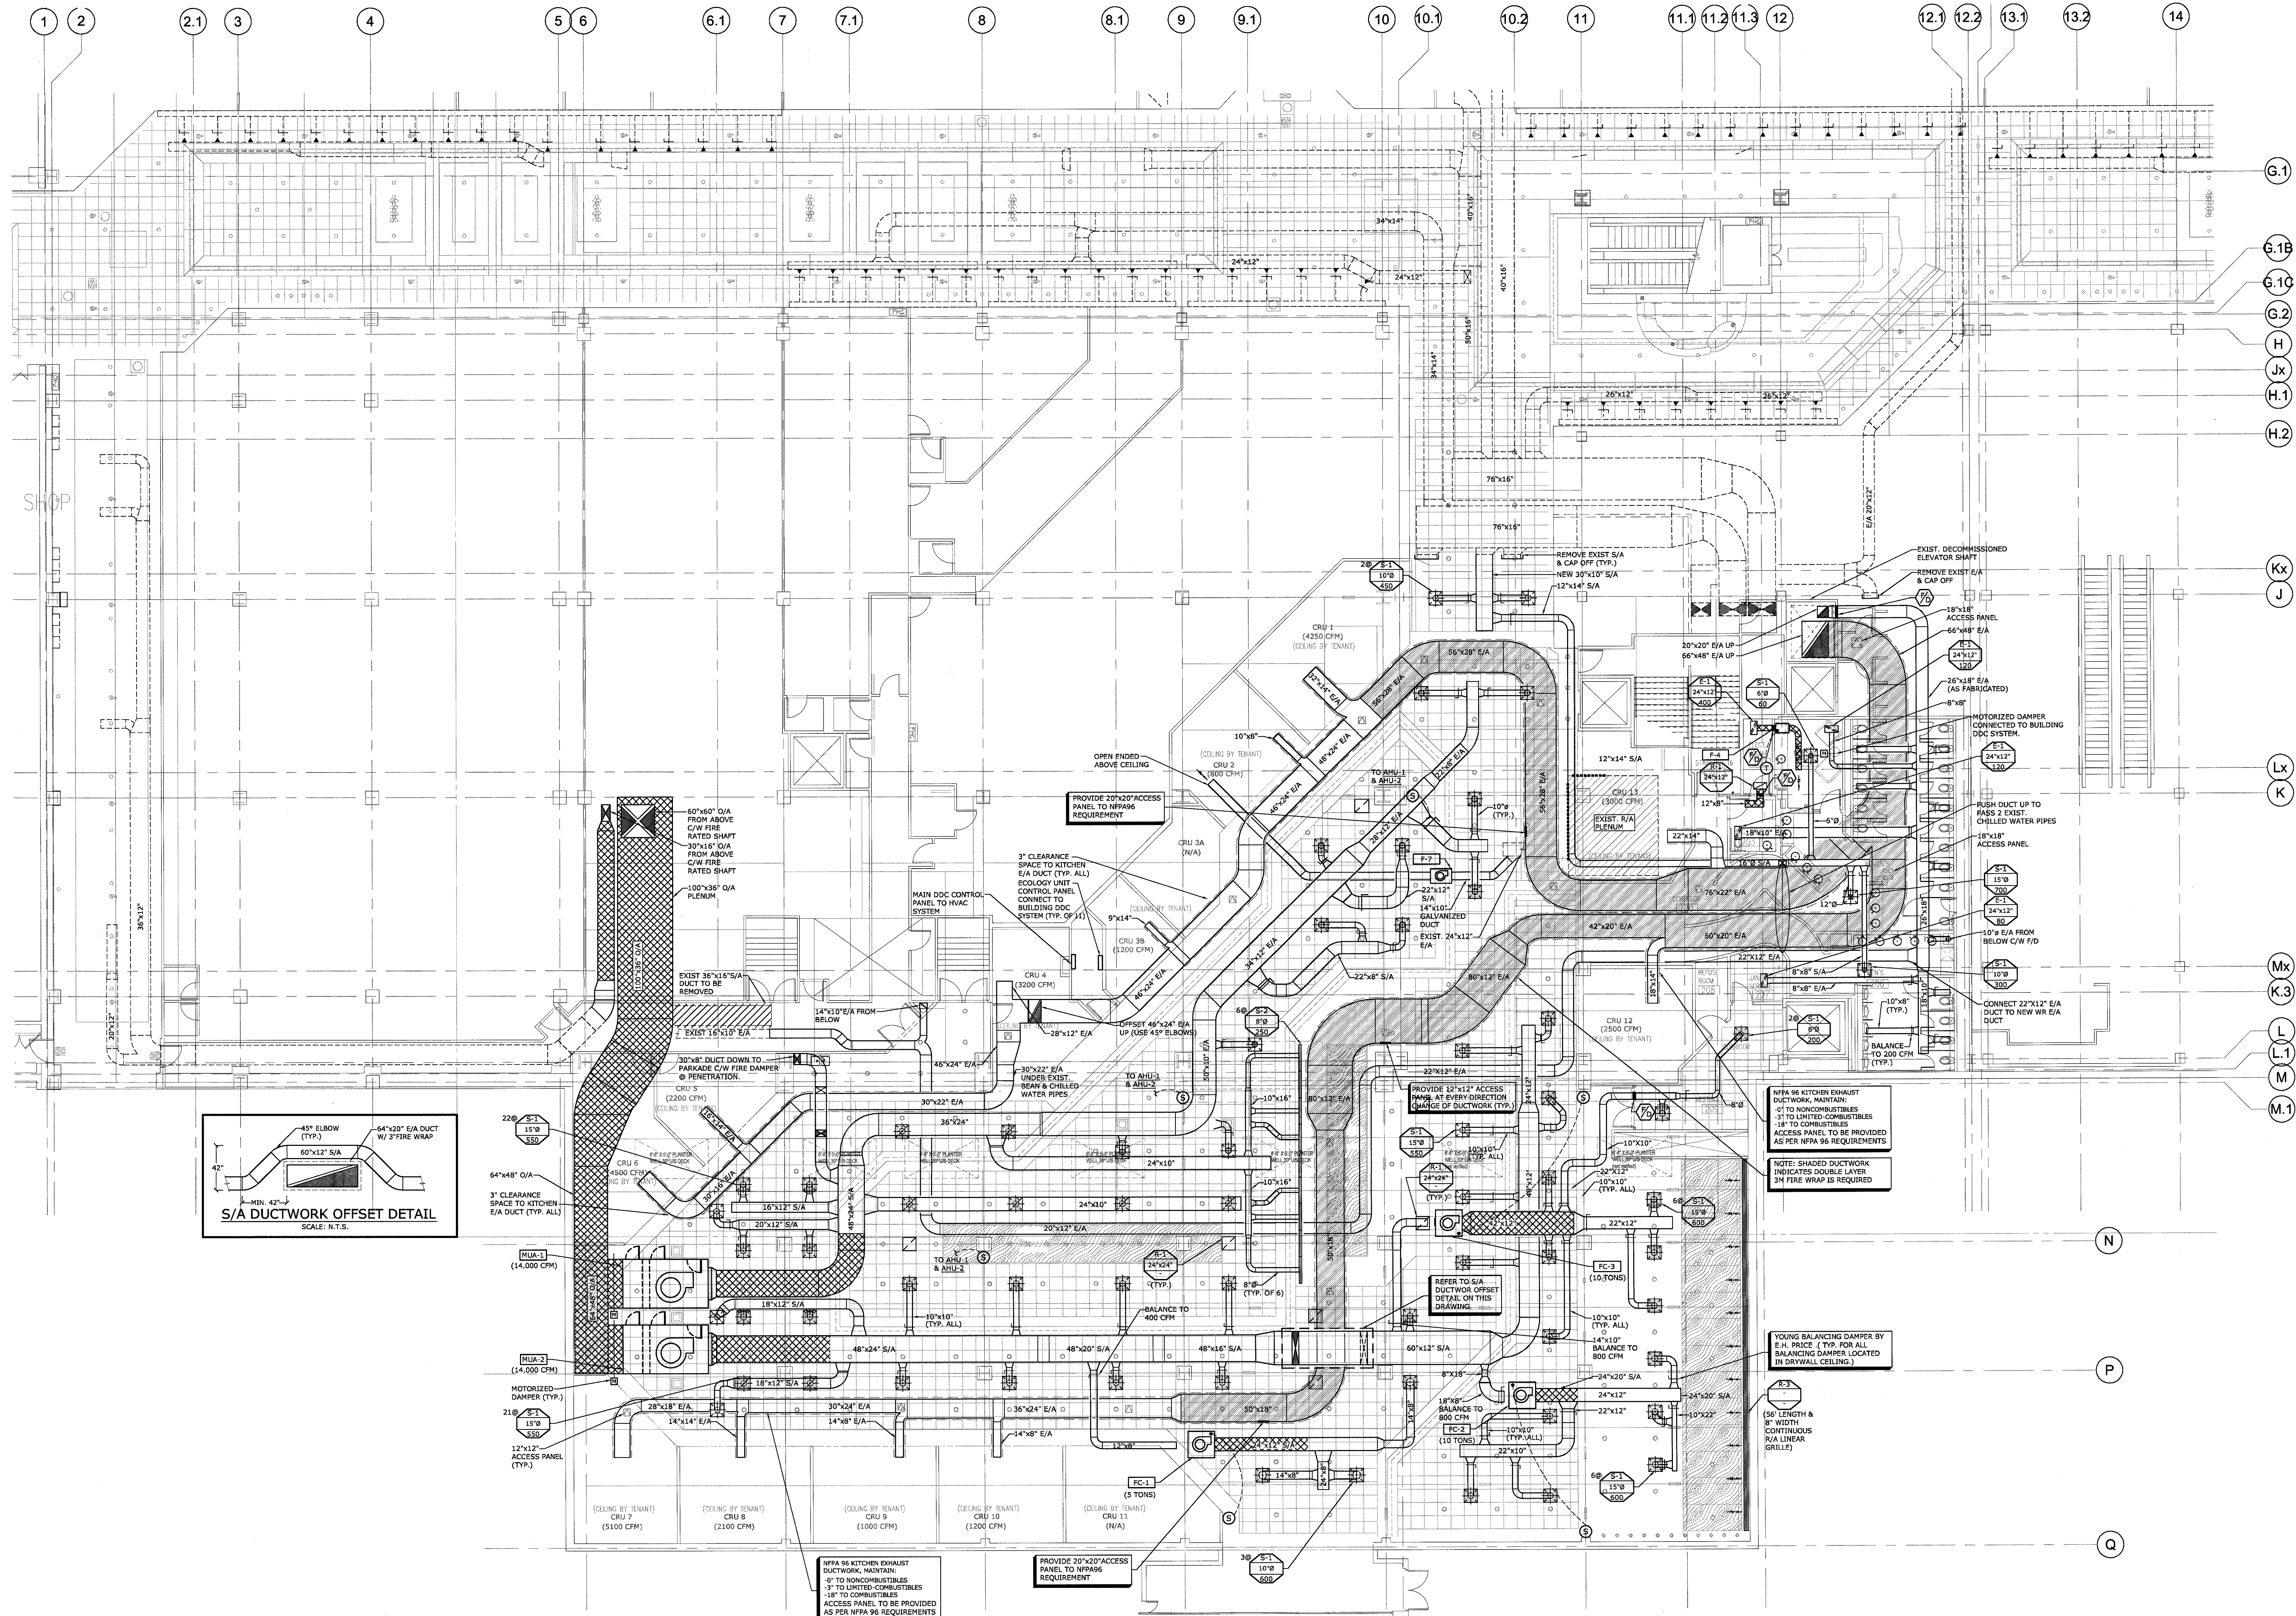

PARTIAL MAIN FLR PLAN - HVAC
SCALE: 1/4" = 1'-0"

DIV 15 MECHANICAL
CERTIFIED AS-BUILT
DATE: 11/22/06
SIGNATURE: [Signature]

RECORD DRAWING
DATE: NOVEMBER 23, 2006

RECORD DRAWING	11/22/06
ISSUED FOR CONSTRUCTION	01/09/06
POST TENDR ADD. M-3	11/29/05
MECH. ADDENDUM M-2	11/10/05
ISSUED FOR TENDER	10/18/05
ISSUED FOR BP	09/19/05
ISSUED FOR BUDGET PRICING	08/16/05
REVISIONS / ISSUES	DATE

Cadillac Fairview
THE CADILLAC FAIRVIEW CORPORATION LTD.
PACIFIC CENTRE
BLOCK 42
BASE BUILDING
ALTERATIONS
VANCOUVER, BRITISH COLUMBIA

PACIFIC CENTRE

cobalt
Cobalt Engineering
Suite 305 - 625 Howe Street
Vancouver BC Canada V6C 2T6
604.687.1800 Telephone
604.687.1802 Facsimile
E-Mail: info@cobaltengineering.com
Project Reference No: 01-9097-092

PARTIAL MAIN FLR PLAN - HVAC

SCALE:	AS NOTED	PROJECT No.	
DRAWN BY:	JN	01-9097-092	
CHECKED:	KC		
		SHEET No.	M-5 of 8